


EXISTING NORTH ELEVATION
1:50@A1

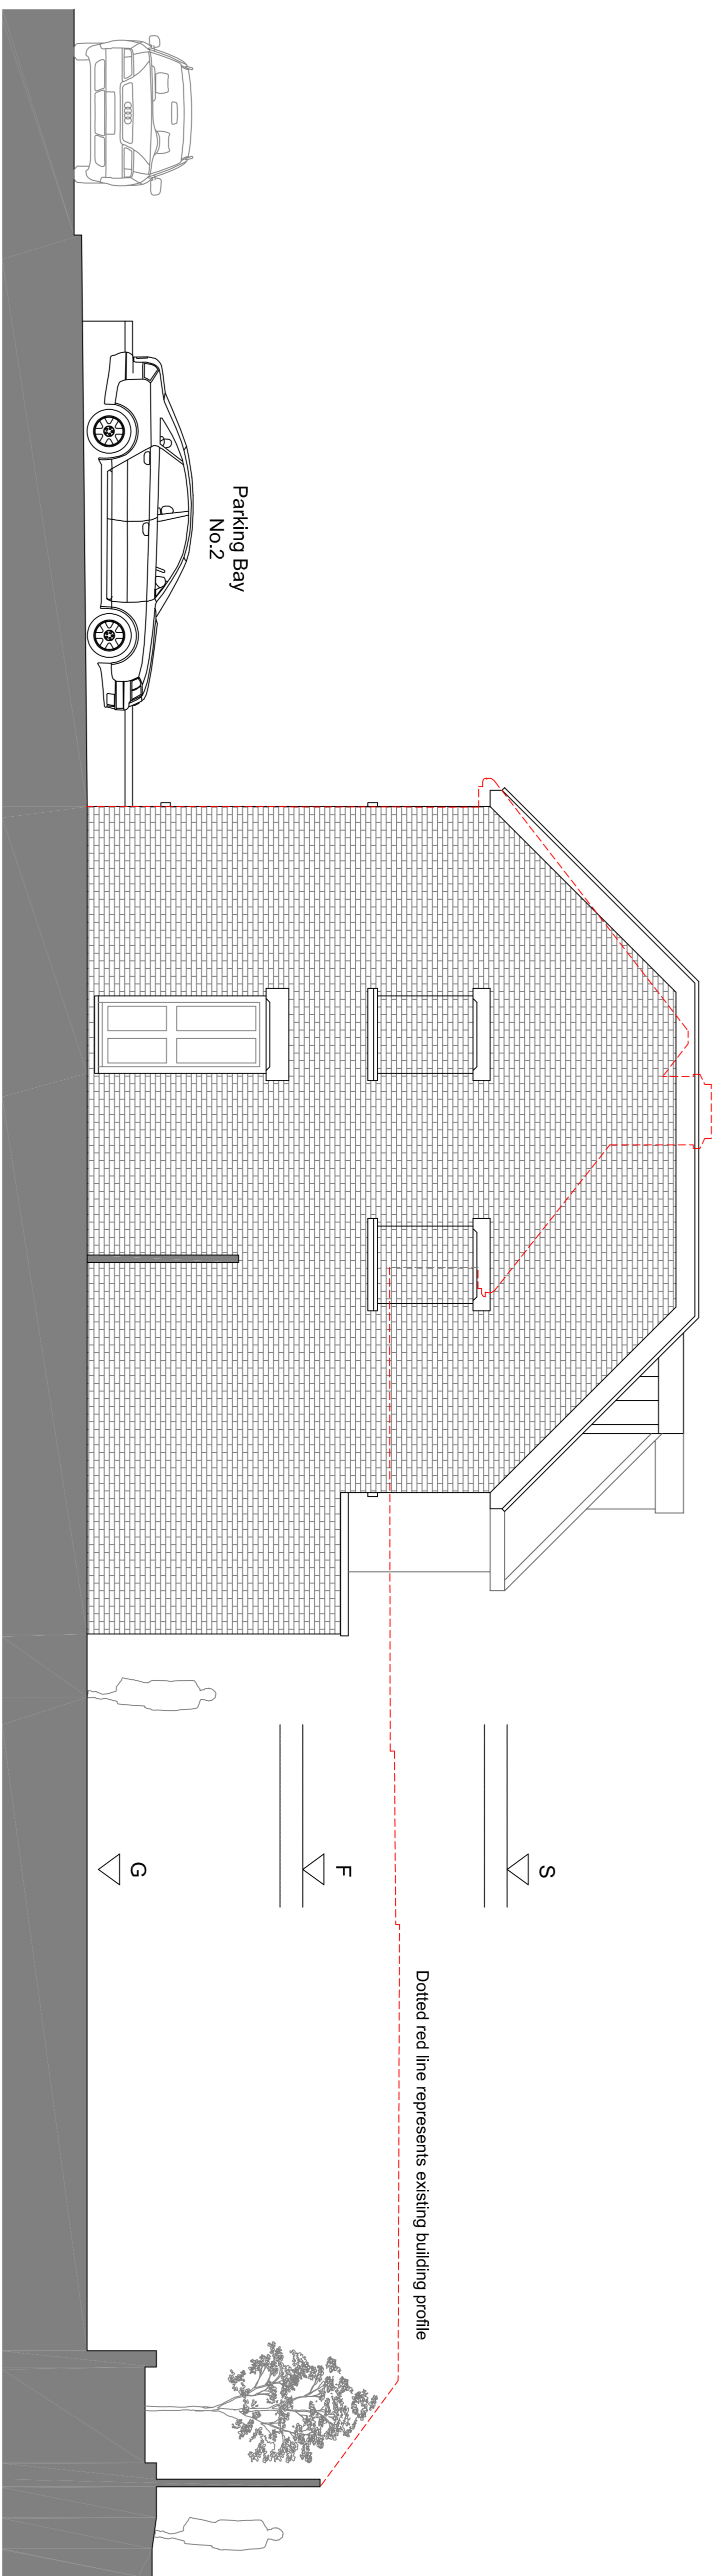

PROPOSED NORTH ELEVATION
1:50@A1

Parking Bay
No.2

Dotted red line represents existing building profile



1. THE DIMENSIONS SHOWN ON THIS DRAWING HAVE BEEN BASED UPON CLIENT SUPPLIED DRAWINGS FOR PLANNING USE ONLY. NOT FOR CONSTRUCTION PURPOSES.
2. ALL LEVELS AND DIMENSIONS TO BE CHECKED ON SITE AND ANY DISCREPANCIES NOTED TO THE ARCHITECT IMMEDIATELY.
3. THIS DRAWING IS TO BE READ IN CONJUNCTION WITH ALL RELEVANT CONSULTANT'S DRAWINGS AND SPECIFICATIONS.
4. THIS DRAWING IS COPYRIGHT AND MUST NOT BE REPRODUCED WITHOUT THE PRIOR WRITTEN AGREEMENT OF THE ARCHITECT.

REVISION

NO. DESCRIPTION

SHOREARCHITECTURE
 PRODUCT
 STURDEY'S MOTORCYCLES GARAGE
 94A, 94C SHIPBOURNE ROAD, TONBRIDGE

SUBJECT
 NORTH ELEVATION
 EXISTING & PROPOSED

SCALE 1:50@A1

DATE 04 2023

JOB NO. SA.144

DRAWING NO. PLEP11

REVISION